



IRRIGATION AS-BUILT LEGEND


- EXISTING IRRIGATION MAINLINE PIPE: CLASS 200 PVC (4-INCH UNLESS OTHERWISE NOTED)
- POINT-OF-CONNECTION (P.O.C.) ASSEMBLY
- IRRIGATION PUMP STATION
- ✕ ISOLATION GATE VALVE ASSEMBLY
- QUICK COUPLING VALVE ASSEMBLY
- ⊗ REMOTE CONTROL VALVE ASSEMBLY FOR SPRINKLER LATERALS
- ⊗ REMOTE CONTROL VALVE ASSEMBLY FOR DRIP LATERALS
- Ⓐ IRRIGATION CONTROLLER UNIT:
 CONTROLLER A: IRRITROL MC-32PLUS-B: 31 STA. USED
 CONTROLLER B: IRRITROL MC-28PLUS-B: 32 STA. USED
 CONTROLLER C: IRRITROL MC-8PLUS-B: 8 STA. USED
- Ⓐ INDICATES CONTROLLER AND STATION NUMBER
- Ⓐ INDICATES LATERAL DISCHARGE (GPM)
- Ⓐ INDICATES VALVE SIZE (INCHES)
- SPRAYS INDICATES TYPE OF SPRINKLER

**IRRIGATION AS-BUILT PLAN PHASE 1
 BUFFALO CREEK SUBDIVISION**

WELLINGTON, COLORADO

DATE: OCTOBER 13, 2024
 REVISIONS:

HINES IRRIGATION CONSULTANTS, INC.
 SYSTEM DESIGN AND WATER MANAGEMENT SERVICES
 344 E. FOOTHILLS PARKWAY, SUITE 11-12
 FORT COLLINS, COLORADO 80525
 Telephone: 970.226.9245
 Fax: 970.226.4660

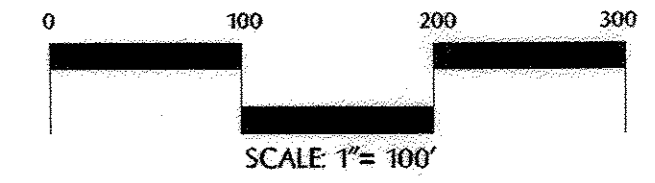

PINECREST
 PLANNING AND DESIGN
 4225 Westshore Way • Fort Collins, CO 80525
 (970) 226-1655 • Fax (970) 226-1635